

115-PLC-03

FIELD

WIREWAY

115-PDC-01

FIELD

MOTOR RUN OUTPUT 4BK 1R6 0:7/07
PLC ADDR 1R6 0:7/07
REFER DWG 2304-W-E327


MOTOR AUTO INPUT 2BK 1R6 1:1/23
PLC ADDR 1R6 1:1/23
REFER DWG 2304-W-E321

MOTOR RUN CONFIRM INPUT 2WH 1R6 1:1/22
PLC ADDR 1R6 1:1/22
REFER DWG 2304-W-E321

MOTOR FAULT INPUT 3WH 1R6 1:1/24
PLC ADDR 1R6 1:1/24
REFER DWG 2304-W-E321

+24 Vdc CONTROL SUPPLY
REFER DWG 2304-W-E304

MOTOR CURRENT INPUT PLC SBR 1R5 A:1.02-
ADDR 1R5 A:1.02 REFER 5WH 1R5 A:1.02+
DWG 2304-W-E311

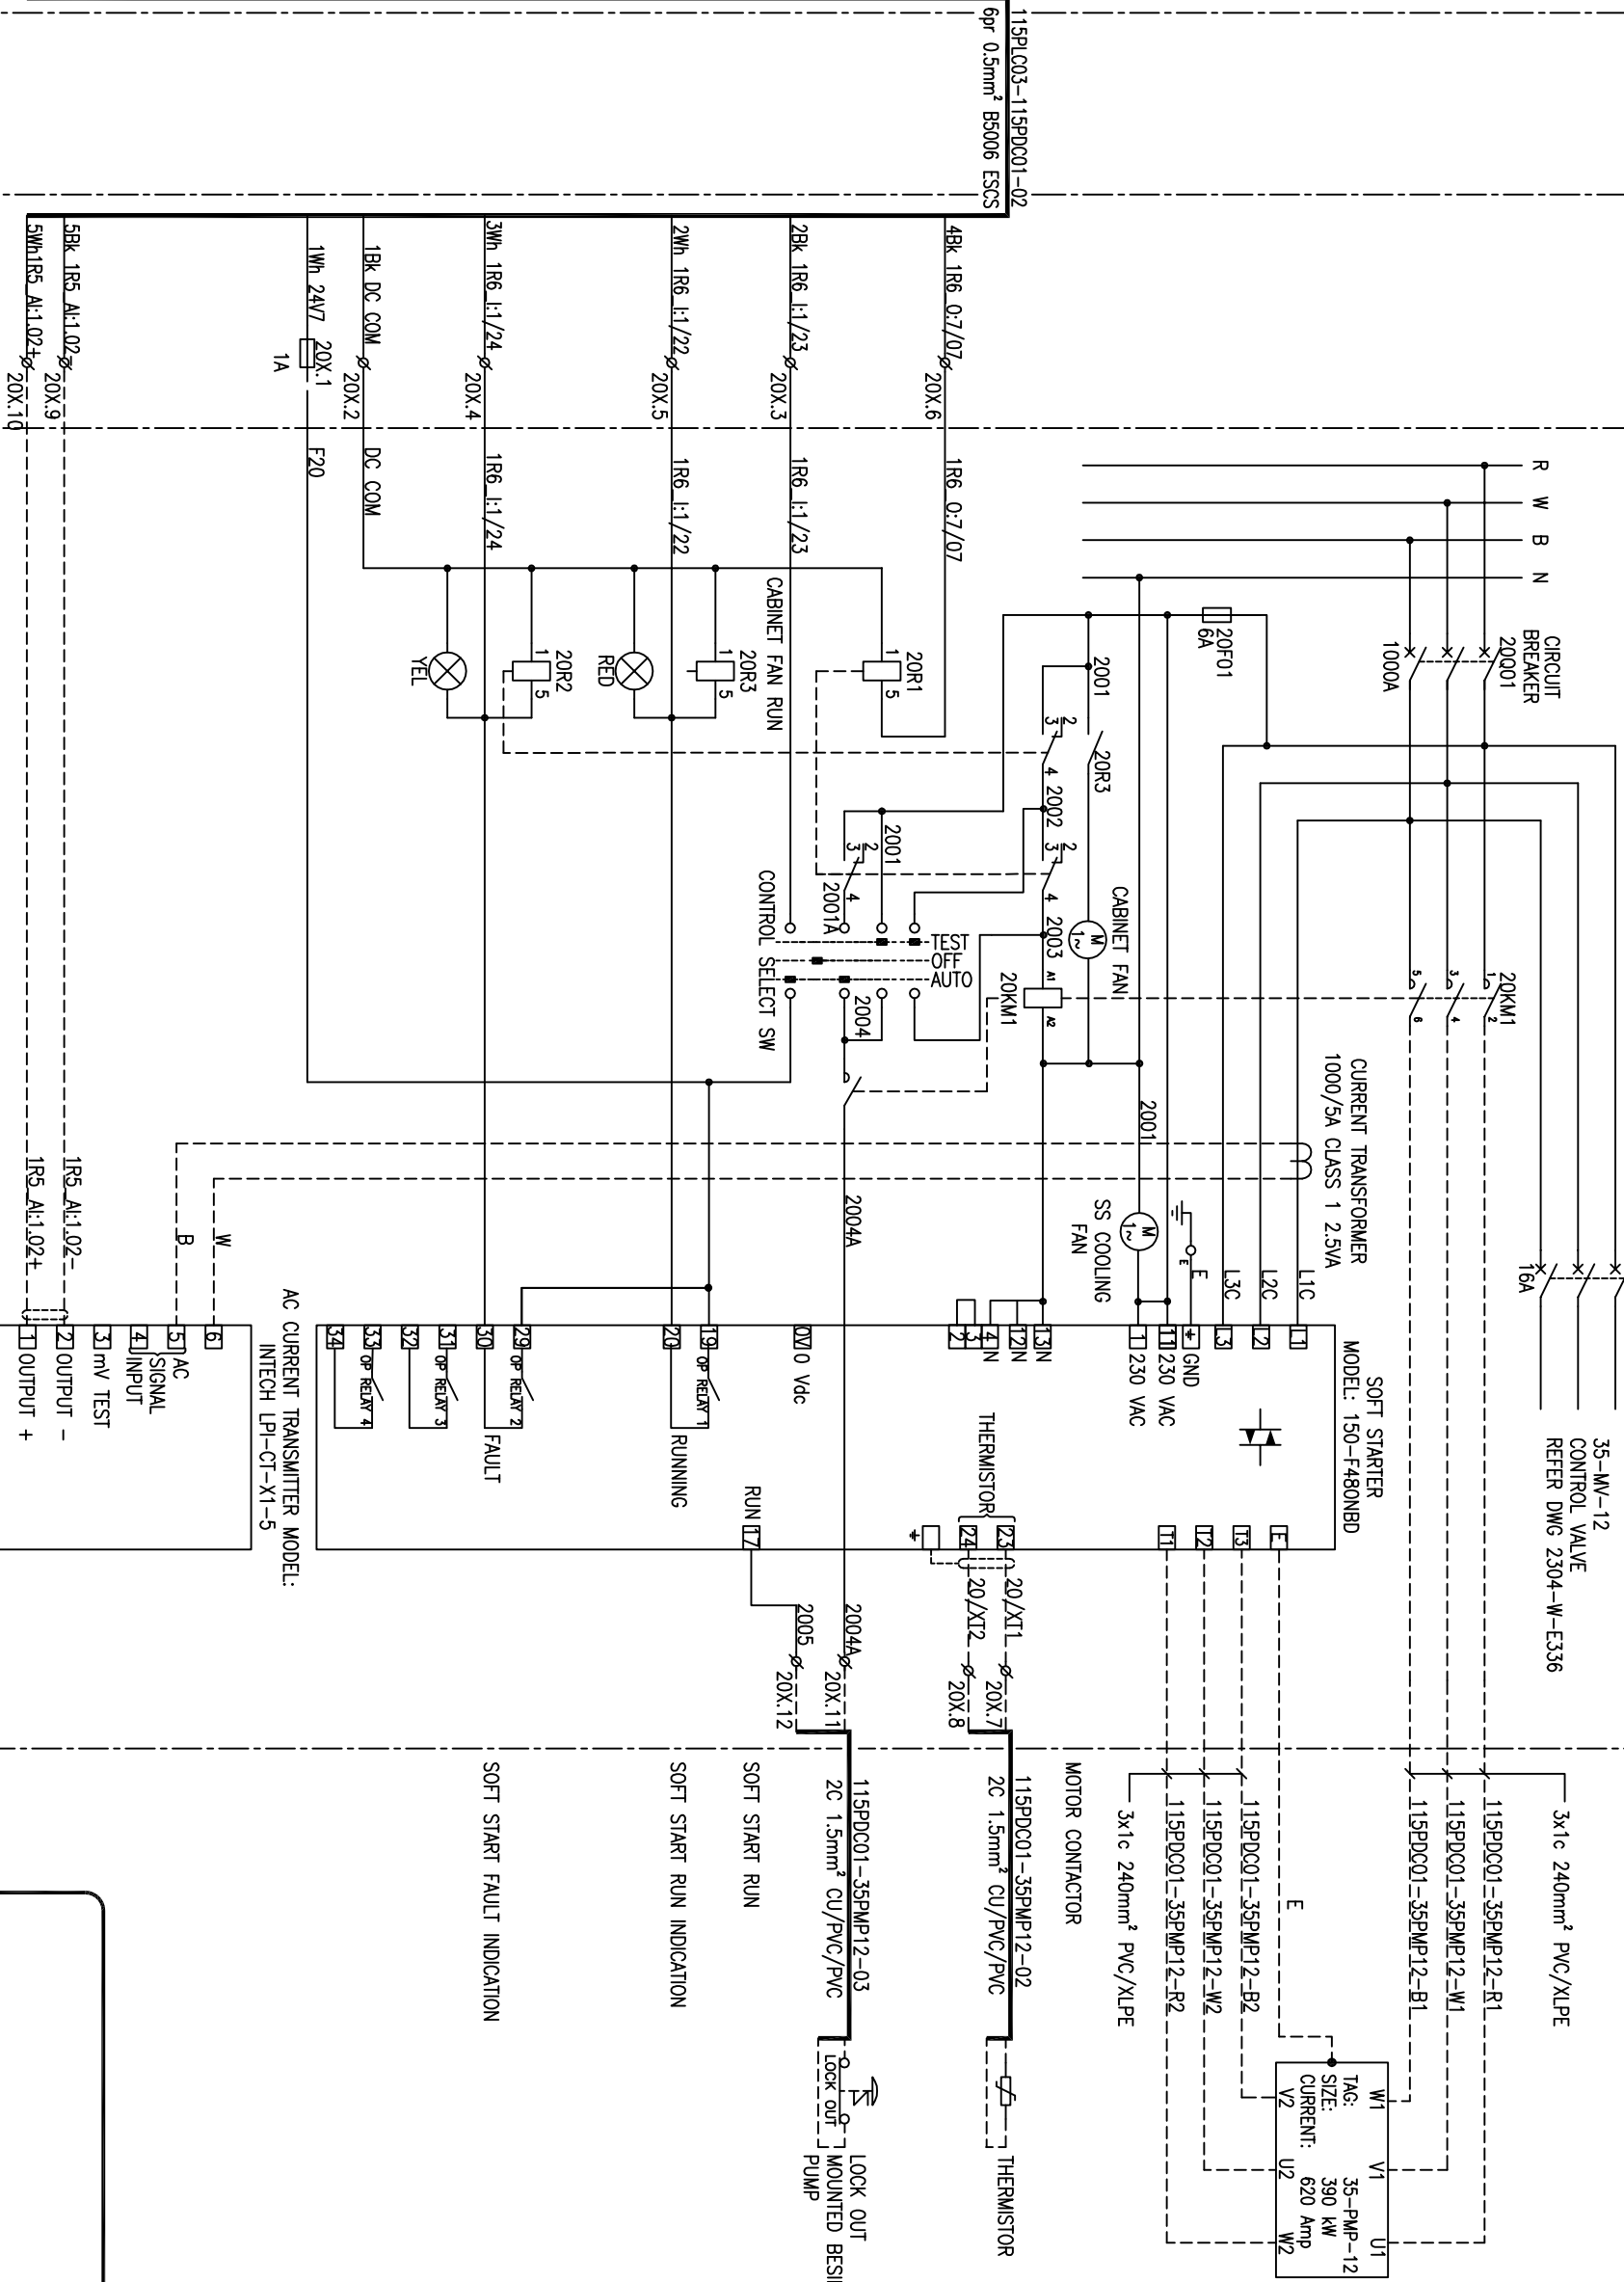

References

Project File No.	Date	Recomm'd
2304-W-E020-1		

File name: 2304-W-E020-1

By	Checked	Date
MM		

Designed: MM

Drawn	Approved	Date
ND		

Drawn: ND

Recomm'd	Date

Recomm'd: -

Approved

Date: / /

AS BUILT
Current Electrical 2000 Ltd

WALLA WATER TREATMENT PLANT
ELECTRICAL & CONTROL EQUIPMENT
TREATED WATER HIGH LIFT PUMP 5 35-PMP-12



Scale: (A1 original)
NTS

Contract No. WSC 23/04
Drawing No. 2304-W-E020
Sheet 1 of 1

Rev	Date	By	Chk Appr.
1	01 APR 2011	MM	
2	29 MAY 2010	MM	
3	03 MAY 2010	MM	
4	06 APR 2010	MM	